


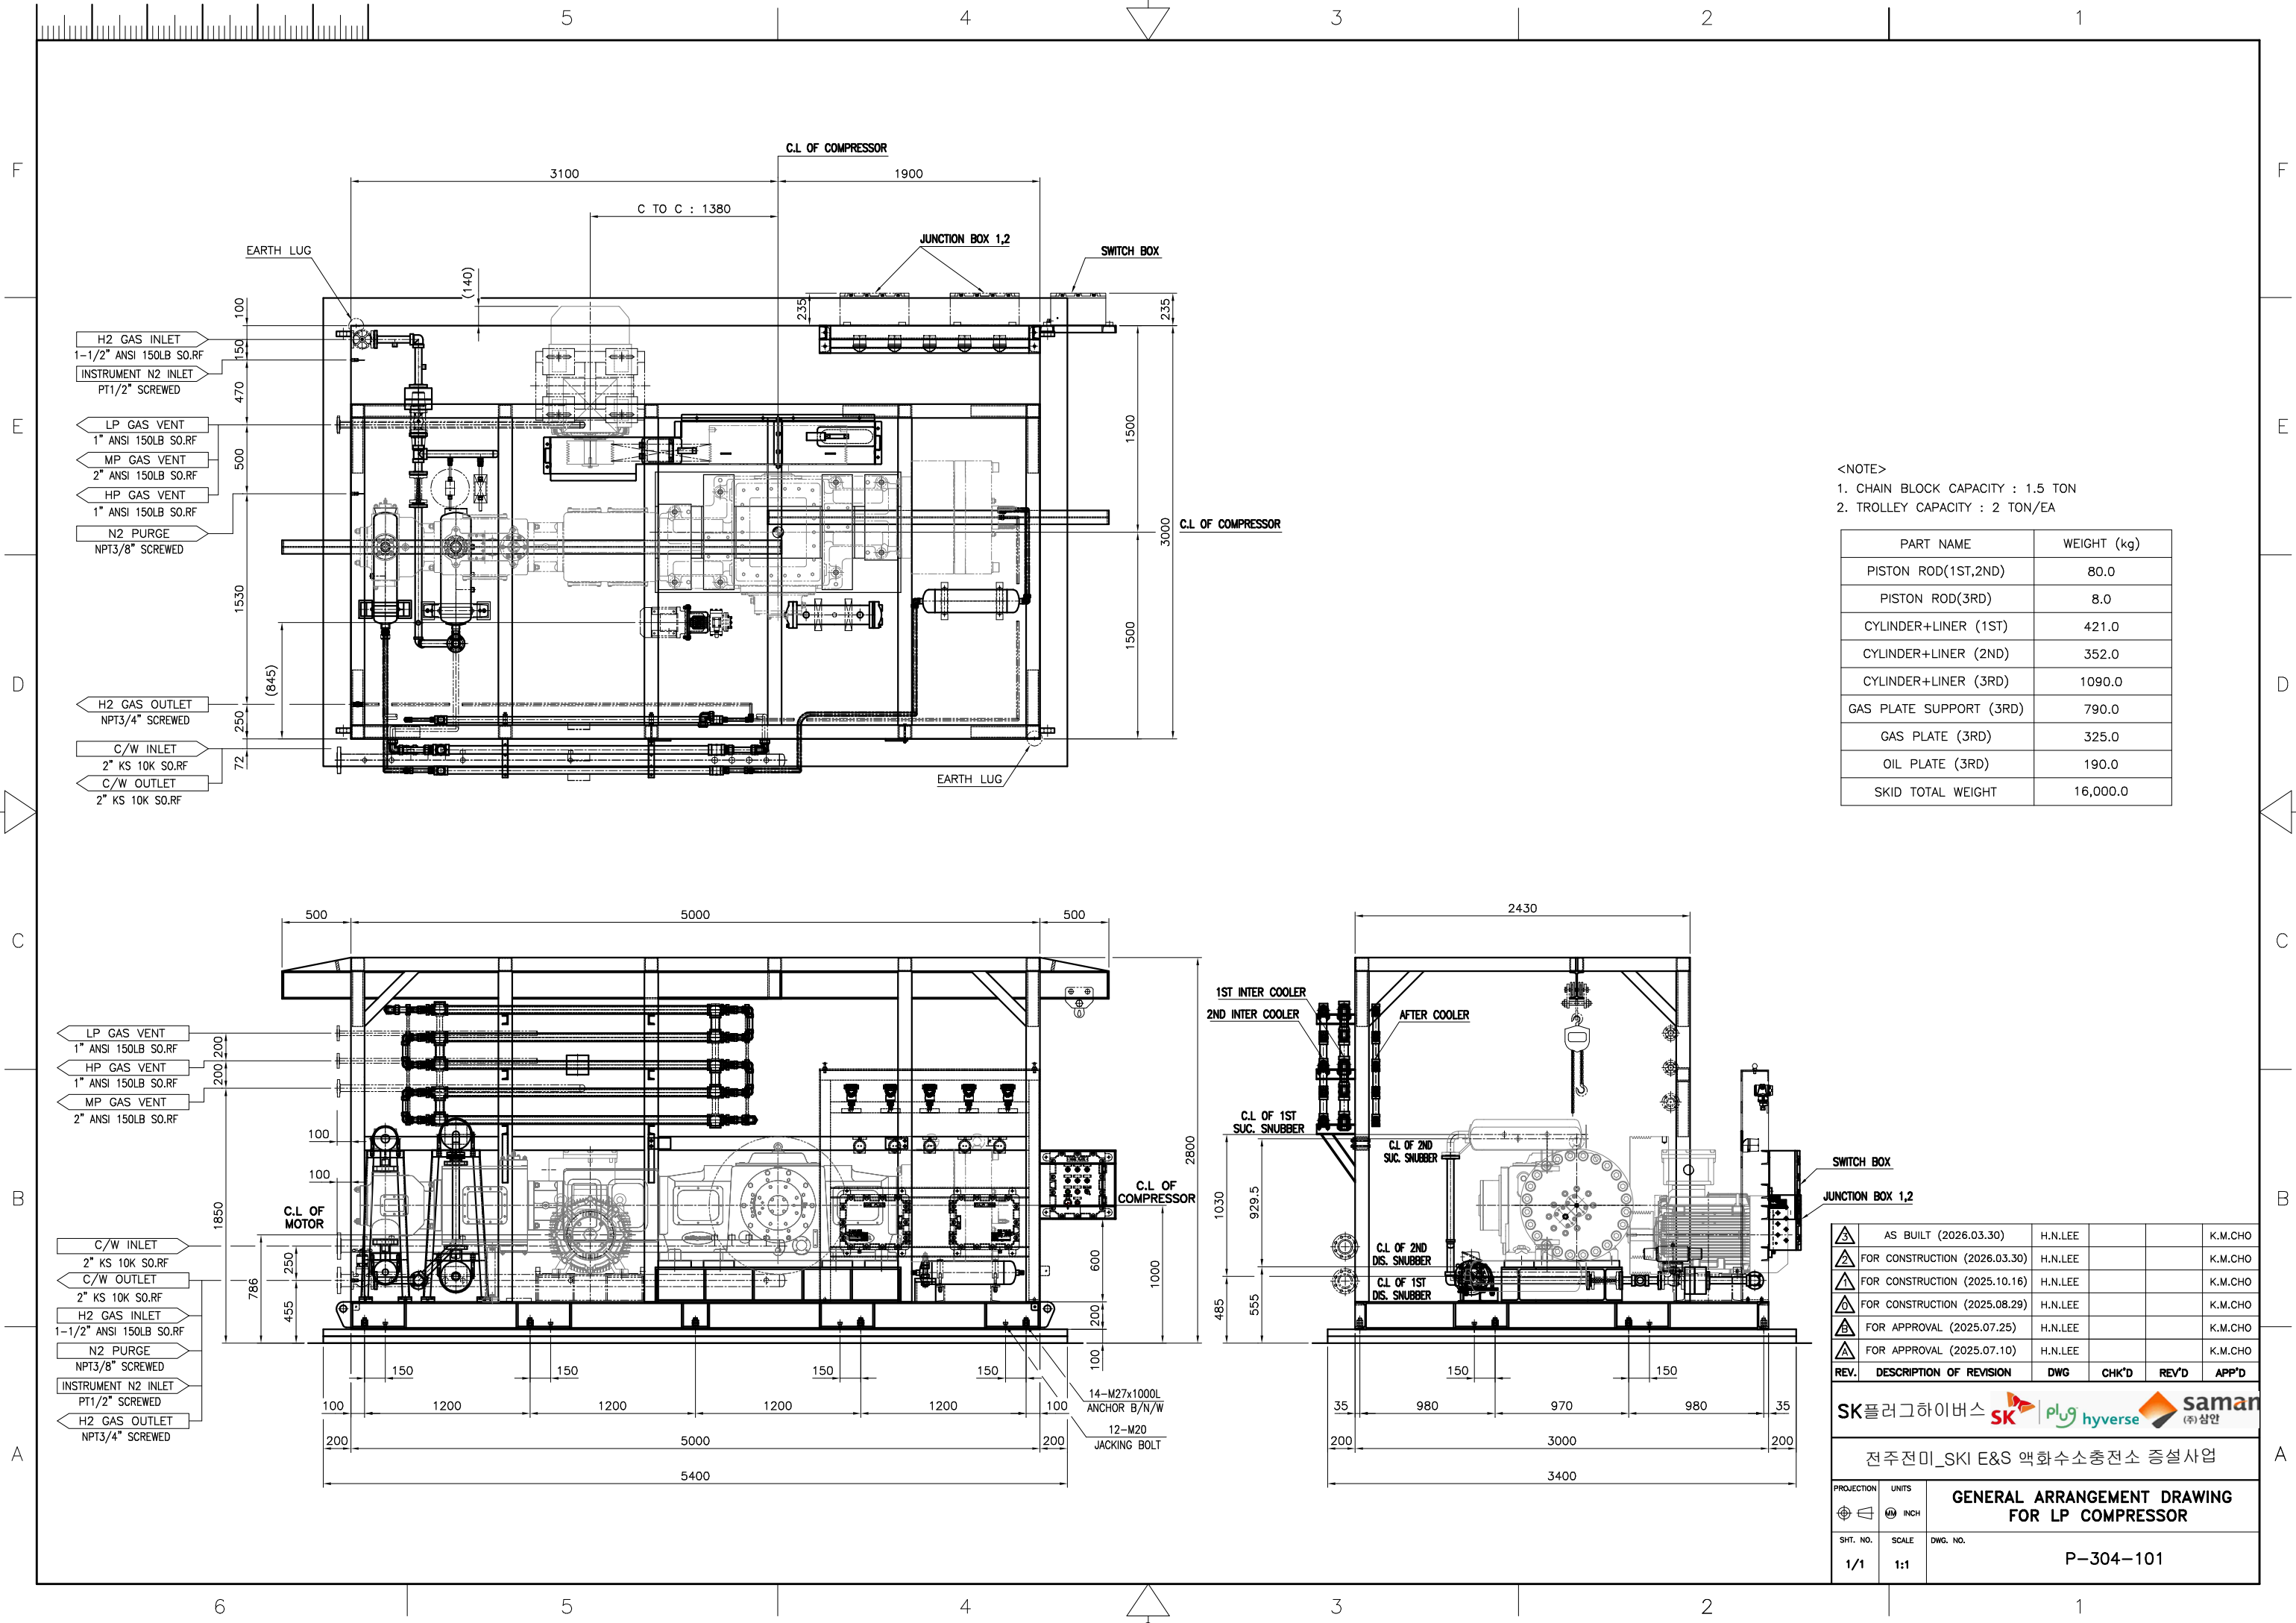

- <NOTE>
1. CHAIN BLOCK CAPACITY : 1.5 TON
2. TROLLEY CAPACITY : 2 TON/EA

PART NAME	WEIGHT (kg)
PISTON ROD(1ST,2ND)	80.0
PISTON ROD(3RD)	8.0
CYLINDER+LINER (1ST)	421.0
CYLINDER+LINER (2ND)	352.0
CYLINDER+LINER (3RD)	1090.0
GAS PLATE SUPPORT (3RD)	790.0
GAS PLATE (3RD)	325.0
OIL PLATE (3RD)	190.0
SKID TOTAL WEIGHT	16,000.0

	AS BUILT (2026.03.30)	H.N.LEE			K.M.CHO
	FOR CONSTRUCTION (2026.03.30)	H.N.LEE			K.M.CHO
	FOR CONSTRUCTION (2025.10.16)	H.N.LEE			K.M.CHO
	FOR CONSTRUCTION (2025.08.29)	H.N.LEE			K.M.CHO
	FOR APPROVAL (2025.07.25)	H.N.LEE			K.M.CHO
	FOR APPROVAL (2025.07.10)	H.N.LEE			K.M.CHO
REV.	DESCRIPTION OF REVISION	DWG	CHK'D	REV'D	APP'D

SK플러그하이버스 SK hyverse saman (주)삼안

전주전미_SKI E&S 액화수소충전소 증설사업

PROJECTION	UNITS	GENERAL ARRANGEMENT DRAWING FOR LP COMPRESSOR	
SHT. NO.	SCALE	DWG. NO.	P-304-101
1/1	1:1		